General Notes:

Timbers to be #1 Rough Sawn Native Hemlock
Pegs to be 1" birch.
One coat of stain, oil or urethane to be shop applied on all sides.
All Bolts to be 1" Galvinized Grade A307.
All Steel A36 Galvinized.

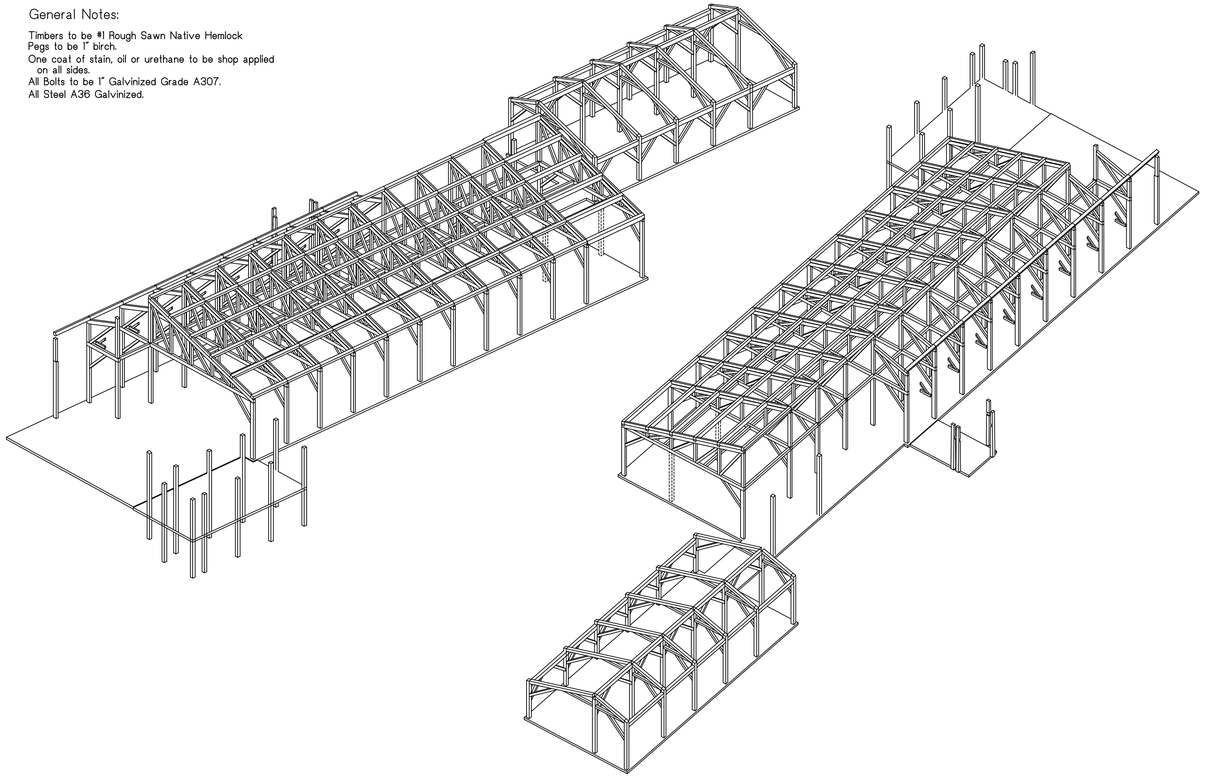

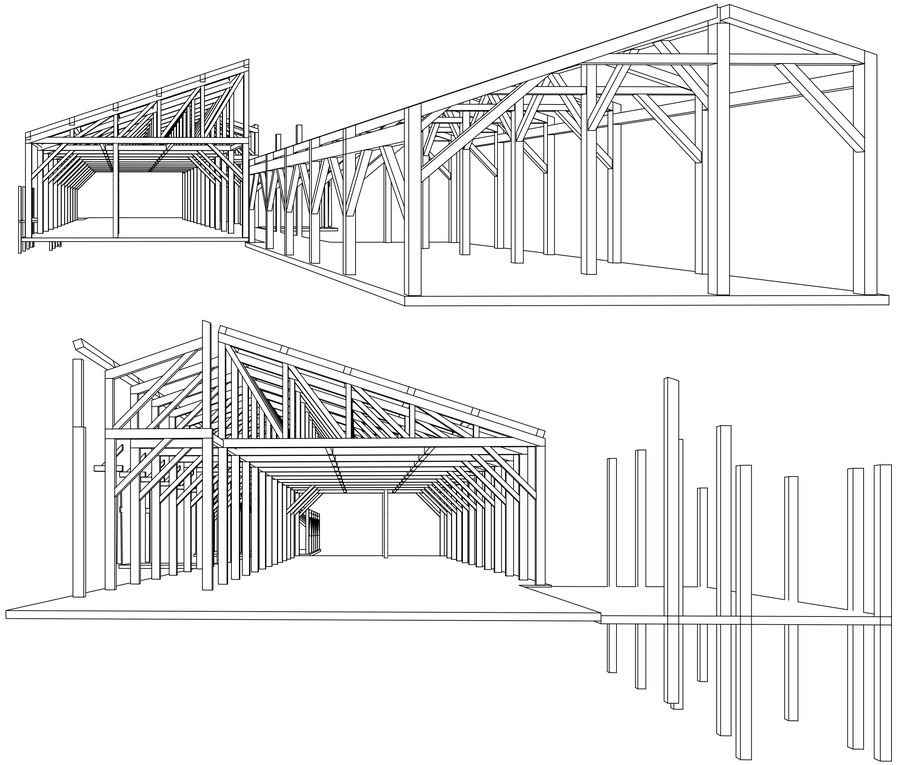

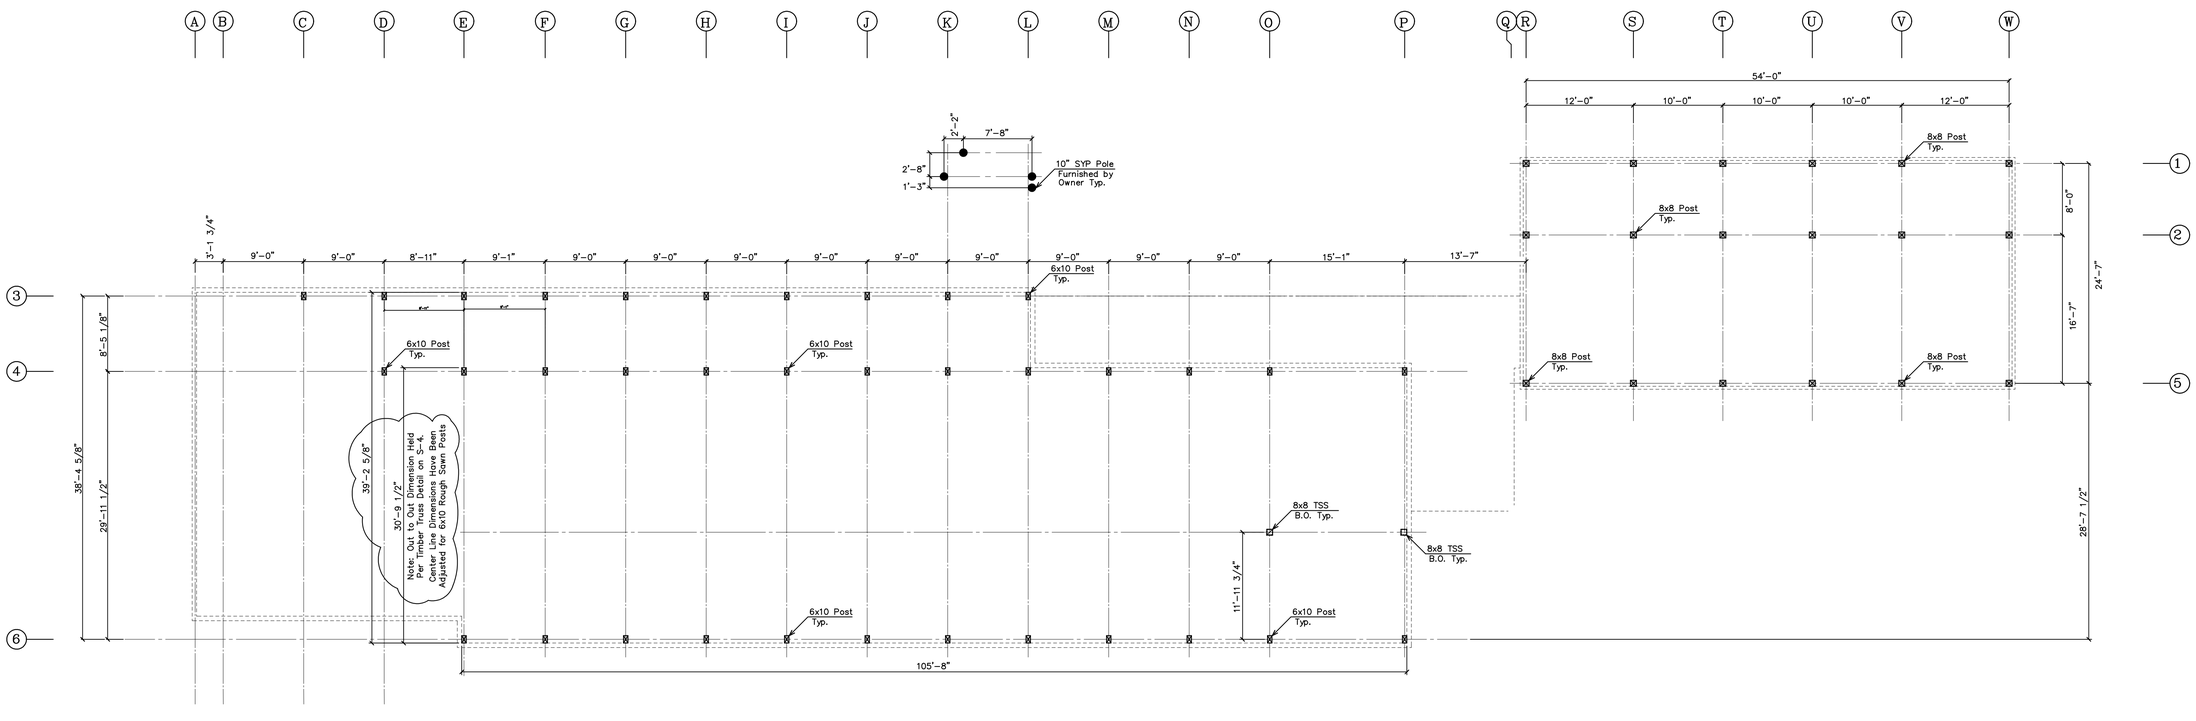

Post Plan

REVISIONS	BY
10/27/06	PJZ
11/20/06	PJZ
1/04/07	PJZ

RED LINE CHECK
BY: DATE:

VERMONT TIMBER WORKS
N. SPRINGFIELD VERMONT
802-886-1917

SHOP DRAWINGS

Post Plan

.

THE ENGINEERING ADVICE, OPINIONS, AND RECOMMENDATIONS IN THIS DRAWING ARE THOSE OF THE LICENSED PROFESSIONAL ENGINEER WHOSE STAMP APPEARS HEREIN, AND NOT OF VERMONT TIMBER WORKS, INC.

PROJECT:
Green Mountain Tech Ctr.
Heavy Timber Trusses
Hardwick, VT

DRAWN : D.F.
CHECKED :
DATE : 10/5/06
SCALE : 1/8"=1'-0"
JOB NO. :
SHEET F-1
OF SHEETS

COPYRIGHT VERMONT TIMBER WORKS, INC.
THIS DRAWING MAY BE UTILIZED ONLY FOR THE WORK SHOWN THEREIN AT THE SITE SPECIFIED. ANY OTHER USE OF THIS DRAWING INCLUDING, WITHOUT LIMITATION, ANY REPRODUCTION OR ALTERATION OF THIS DRAWING WITHOUT THE PRIOR WRITTEN APPROVAL OF VERMONT TIMBER WORKS, INC. IS A VIOLATION OF LAW AND PROHIBITED.